

## RECORD DRAWINGS



HCC Property Services,  
Three Minsters House,  
76 High Street, Winchester SO23 8UL.  
tel: (01962) 847801

### Notes

1 This drawing is © copyright Hampshire County Council 2012. No unauthorised reproduction permitted. All rights reserved.

2 No dimensions are to be scaled from this drawing

3 © Crown copyright and database rights 2017 Ordnance Survey 100019180. Use of this data is subject to terms and conditions. You are granted a non-exclusive, royalty free, revocable licence solely to view the Licensed Data for non-commercial purposes for the period during which HCC makes it available. You are not permitted to copy, sub-license, distribute, sell or otherwise make available the Licensed Data to third parties in any form. Third party rights to enforce the terms of this licence shall be reserved to Ordnance Survey

rev	description	date	by
A	Updated to show swimming pool refurb	04/12/12	HJP
B	HSS amendments added & updated to suit Site Building Plan.	10/09/18	HJP
C	Classroom extension added.	29/07/19	clw
D	HSS amendments added.	18/11/19	HJP

PROJECT  
**Bishops Waltham Junior School**  
**Bishops Waltham, SO32 1EP**  
**2273-10008000575**

SCALE	DATE	DRAWN.	CHKD.
1:100 @ A1 1:200 @ A3	Dec 2007	SPINT	---

SHEET CONTENTS  
**Property Records**  
**Ground Floor Plan**  
**Sheet 2 of 4**


DRAWING No.	REVISION
<b>01_Rec/002</b>	<b>D</b>

FILE REF. 2273-10008000575-BishopsWalthamJuniorSchool.dwg





UPSTAIRS

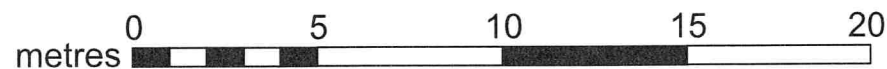

## RECORD DRAWINGS



HCC Property Services,  
Three Minsters House,  
76 High Street, Winchester SO23 8UL.  
tel: (01962) 847801

Notes		
1 This drawing is © copyright Hampshire County Council 2012. No unauthorised reproduction permitted. All rights reserved.	3 © Crown copyright and database rights 2017 Ordnance Survey 100019180. Use of this data is subject to terms and conditions. You are granted a non-exclusive, royalty free, revocable licence solely to view the Licensed Data for non-commercial purposes for the period during which HCC makes it available. You are not permitted to copy, sub-license, distribute, sell or otherwise make available the Licensed Data to third parties in any form. Third party rights to enforce the terms of this licence shall be reserved to Ordnance Survey	
2 No dimensions are to be scaled from this drawing		

rev	description	date	by
A	Updated to show swimming pool refurb	04/12/12	HJP
B	HSS amendments added & updated to suit Site Building Plan.	10/09/18	HJP
C	Classroom extension added.	29/07/19	clw
D	HSS amendments added.	18/11/19	HJP

PROJECT				SHEET CONTENTS		
Bishops Waltham Junior School Bishops Waltham, SO32 1EP 2273-10008000575				Property Records First Floor Plan Sheet 4 of 4		
SCALE 1:100 @ A1 1:200 @ A3	DATE Dec 2007	DRAWN. SPINT	CHKD. ---	DRAWING No. 01_Rec/004	REVISION D	FILE REF. 2273-10008000575-BishopsWalthamJuniorSchool.dwg